

Work Order ID 60976

August 3, 2010 1:33:27 PM

Page 1

PRELIMINARY ISSUE

Item ID: D4155-1

Accept

Revision ID: PRELIM

Item Name: Bar

Start Date: 8/03/10 Start Qty: 2.00

Required Date: 8/05/10 Req'd Qty: 2.00

Cust Item ID:

Customer:

Reference:

Approvals:

Process Plan:

Date:

Tooling:

Date:

QC:

Date:

SPC (Y/N):

Date:

Run

Start

Stop

Sequence ID/
Work Center ID

Operation
Description

Set Up/
Run Hours

Tool ID

Tool #

Plan
Code

Accept
Qty

Reject
Qty

Reject
Number

Insp.
Stamp

Draw Nbr

Revision Nbr

D4155

PA1

100

0.00

Waterjet

FLOW CNC Waterjet

Memo

1-Cut as per Dwg

Dwg Rev: PA1

Prog Rev: PA1

2-Deburr if necessary

0.00

FB 10-8-4

110

QC2- Inspect parts off machine FAI/FAIB

0.00

QC

Quality Control

Memo

0.00

FB 10-8-4

[illegible]

August 3, 2010 1:33:27 PM

1	2	3	466
---	---	---	---	---	---	---	---	---	----	----	-----	-----	
[REDACTED]

Abstract

1
 2
 3
[illegible]

Customer:

[illegible][illegible]

Date:

**Insp.
Stamp**

0.00 - Inspector to RA/Ding

[illegible]

0.00 δ volozlos κ

0.00

Weld per dwg A/R Hardcoat steel Batch: M1/4898 0.00



0.00

0.00

0.00

0.00

EL 10-8-9 12

11 10.08.09

Work Order ID 60976

August 3, 2010 1:33:28 PM



Page 3

Item ID: D4155-1

Accept



Setup Start



Revision ID: PRELIM

Stop



Item Name: Bar

Start Date: 8/03/10

Start Qty: 2.00



Cust Item ID:

Required Date: 8/05/10

Req'd Qty: 2.00



Customer:

Reference:

Run Start



Approvals:

Process Plan:

Date:

Tooling:

Date:

QC:

Date:

SPC (Y/N):

Date:

Stop



Sequence ID/
Work Center ID

Operation
Description

Set Up/
Run Hours

Tool ID

Tool #

Plan
Code

Accept
Qty

Reject
Qty

Reject
Number

Insp.
Stamp

150

QC5- Inspect part completeness to step on W/O

0.00

*inspect to PA 1
Dwg only*



QC

Memo

0.00

Quality Control

8/10/04/16

160

Identify as per dwg & Stock Location: *W/O*

0.00



Packaging

Memo

0.00

Packaging

60976

EL 10-8-9 x0

170

QC21- Final Inspection - Work Order Release

0.00



QC

Memo

0.00

Quality Control

10/10/04

POSITIVE RECALL

EFFECTIVE *10-8-03* AUTH *W*

RELEASED *10-10-04* DATE *10.10.04*

PER ATTACHED ~~RECALL~~ ~~RECALL~~
DWG ~~2010-04-15~~
+ Release on 3

MF 10-10-04

Picklist Print

August 3, 2010 1:33:25 PM

Page 1

Work Order ID: 60976

Parent Item: D4155-1

Parent Item Name: Bar



Start Date: 8/03/10

Required Date: 8/05/10

Start Qty: 2.00

Required Qty: 2.00

Comments: IPP Rev:A 10.08.03 new issue DD verf:EC

Component Item ID/ Item Name	Replacement Item ID	Mfg/ Purch	Bin Item	Primary Location	Last Location	Route Seq ID	Unit of Measure	Qty on Hand	Qty per Kit	Total Qty	Qty Issued	Date Issued	Status
---------------------------------	------------------------	---------------	-------------	---------------------	------------------	-----------------	--------------------	----------------	-------------	--------------	---------------	----------------	--------

M304B0.500X012.000

Purchased

No

100

sf

2.9410

1.27

2.673684



304 BAR .500 X 12.00



1210-8-4

304 BAR .500 X 3.125

Location

Loc Qty

Loc Code

MAT53

2.941


112778

2.941

112320

112320

②

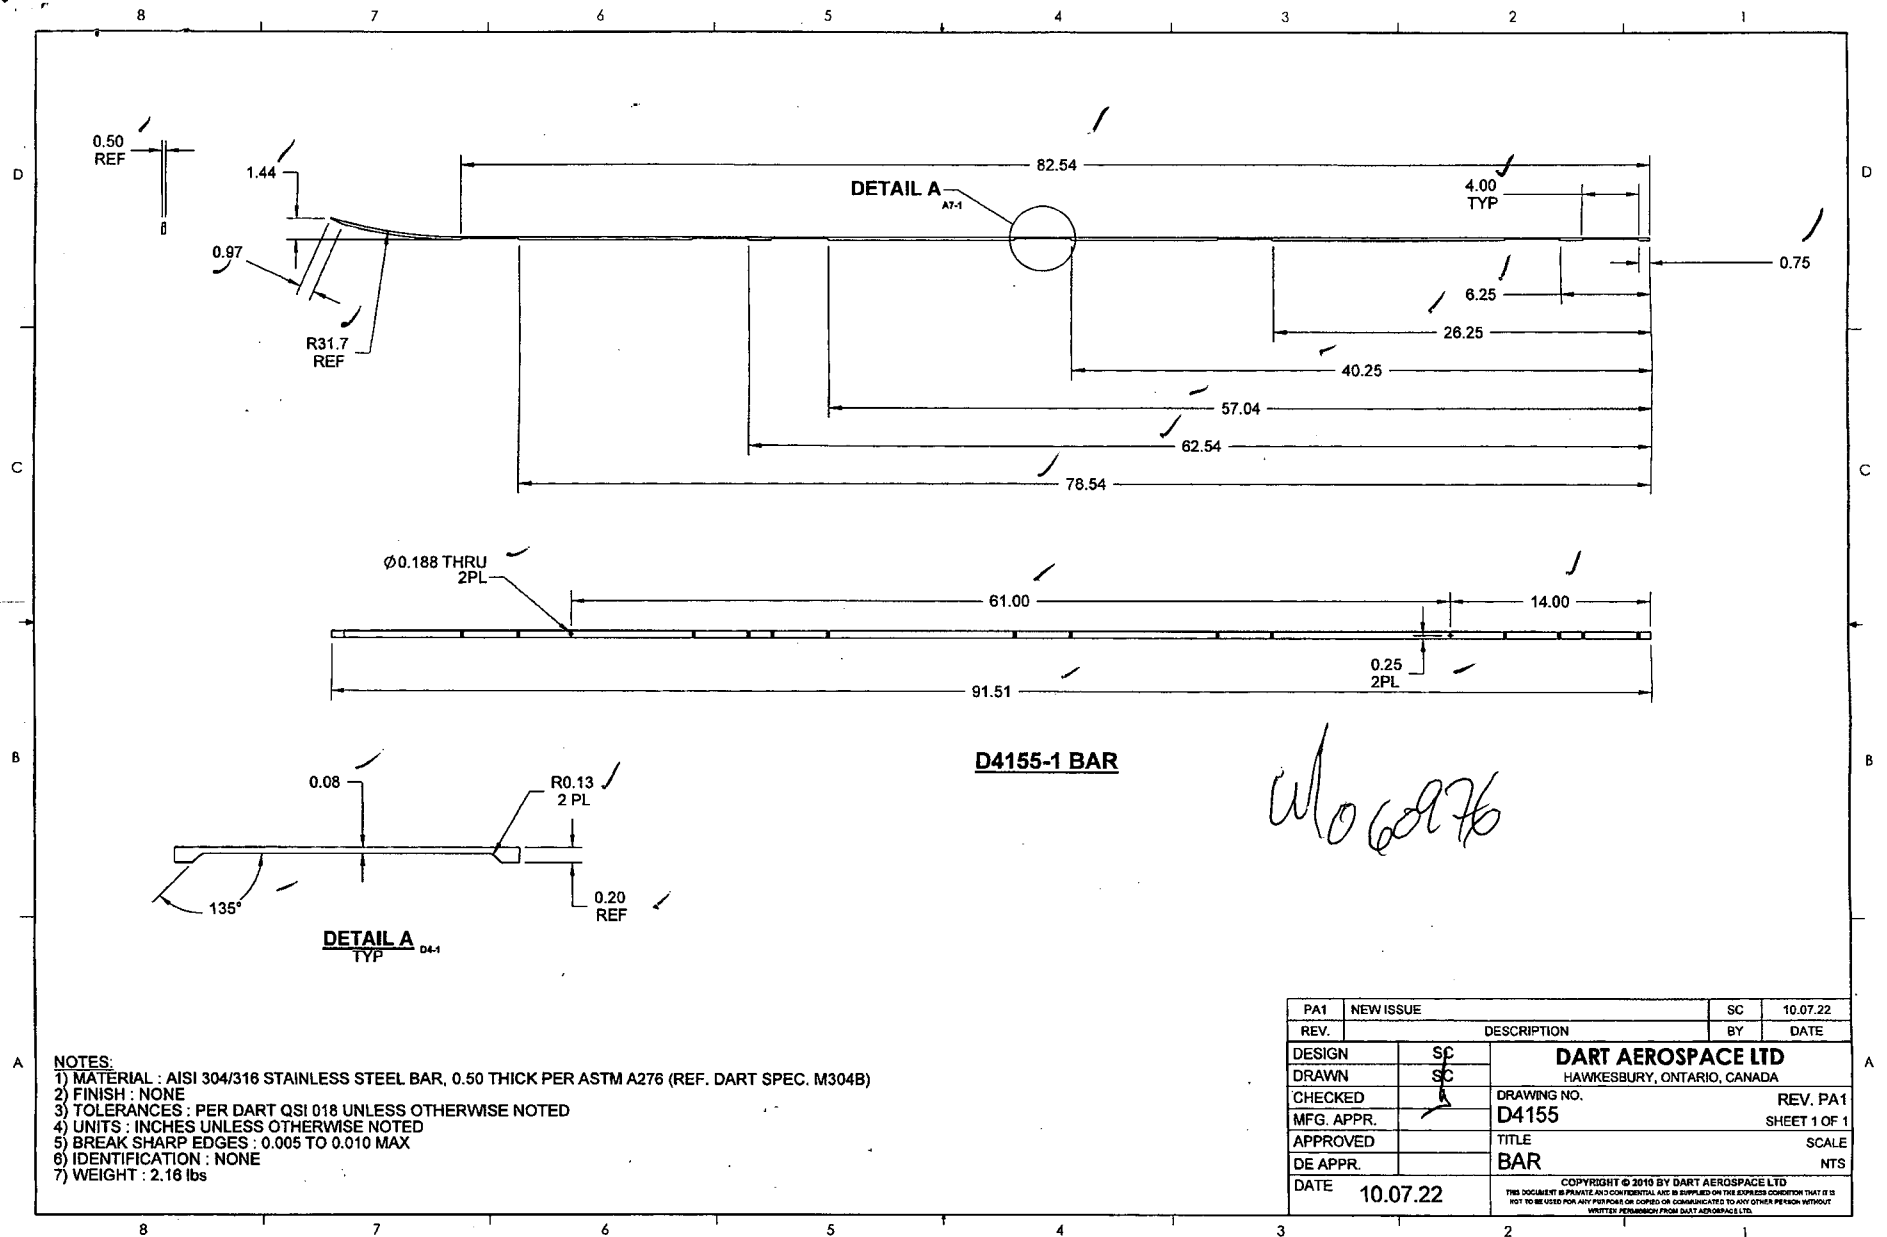

DART AEROSPACE LTD		Work Order: 60976
Description: WEAR BAR		Part Number: D4155-1
Inspection Dwg: D4155-1 Rev: PA1		Page 1 of 1

FIRST ARTICLE INSPECTION CHECKLIST



☒ First Article ☐ Prototype

Drawing Dimension	Tolerance	Actual Dimension	Accept	Reject	Method of Inspection	Comments
.50	$\pm .03$.510	X		V IB 62	
.20	$\pm .030$.201	X		V	
.08	$\pm .030$.083	X		V	
91.51	$\pm .030$	91.51	X		T IB 01	
.75	$\pm .030$.760	X		V	
4.00	$\pm .030$	4.002	X		V	
6.25	$\pm .030$	6.260	X		V	
26.25	$\pm .030$	26.25	X		T	
40.25	$\pm .030$	40.25	X		T	
57.04	$\pm .030$	57.00	X		T	
62.54	$\pm .030$	62.54	X		T	
78.54	$\pm .030$	78.54	X		T	
82.54	$\pm .030$	82.54	X		T	
.97	$\pm .030$.960	X		V	
1.44	$\pm .030$	1.460	X		V	


Measured by: IB	Audited by: S	Prototype Approval: N/A		
Date: 10-8-4	Date: 10/08/05	Date: N/A		
to PA1 Dwg only				
Rev	Date	Change	Revised by	Approved
A		New Issue	KJ/JLM	

8 7 6 5 4 3 2 1

#60976

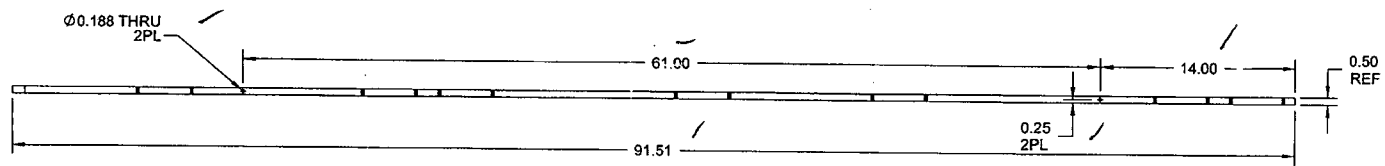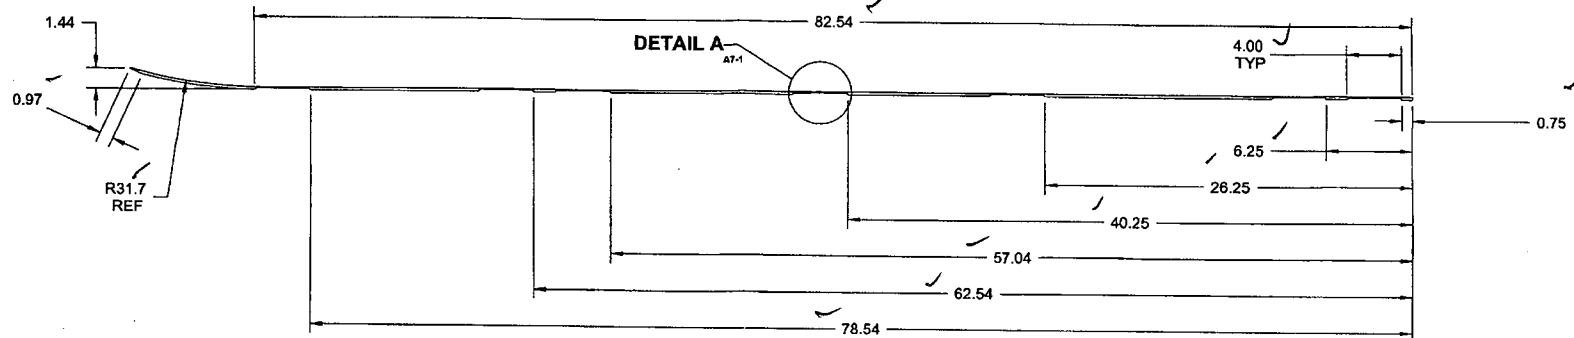

D4155-1 BAR

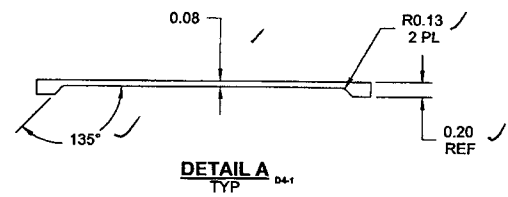

60976

RELEASED
2010-09-15

- NOTES:**
 1) MATERIAL : AISI 304/316 STAINLESS STEEL BAR, 0.50 THICK PER ASTM A276 (REF. DART SPEC. M304B)
 2) FINISH : NONE
 3) TOLERANCES : PER DART QSI 018 UNLESS OTHERWISE NOTED
 4) UNITS : INCHES UNLESS OTHERWISE NOTED
 5) BREAK SHARP EDGES : 0.005 TO 0.010 MAX
 6) IDENTIFICATION : NONE
 7) WEIGHT : 2.16 lbs

A	NEW ISSUE	SC	10.07.22
REV.	DESCRIPTION	BY	DATE
DESIGN	SC	DART AEROSPACE USA, INC. PORT HADLOCK, WA	
DRAWN	SC		
CHECKED	SC	DRAWING NO.	REV. A
MFG. APPR.	SC	D4155	SHEET 1 OF 1
APPROVED	SC	TITLE	SCALE
DE APPR.	SC	BAR	NTS
DATE	10.07.22	COPYRIGHT © 2010 BY DART AEROSPACE USA, INC. THIS DOCUMENT IS PRIVATE AND CONFIDENTIAL AND IS SUPPLIED ON THE EXPRESS CONDITION THAT IT IS NOT TO BE USED FOR ANY PURPOSE OR COPIED OR COMMUNICATED TO ANY OTHER PERSON WITHOUT WRITTEN PERMISSION FROM DART AEROSPACE USA, INC.	

8 7 6 5 4 3 2 1